


FRONT ENTRANCE

LONG HALLWAY

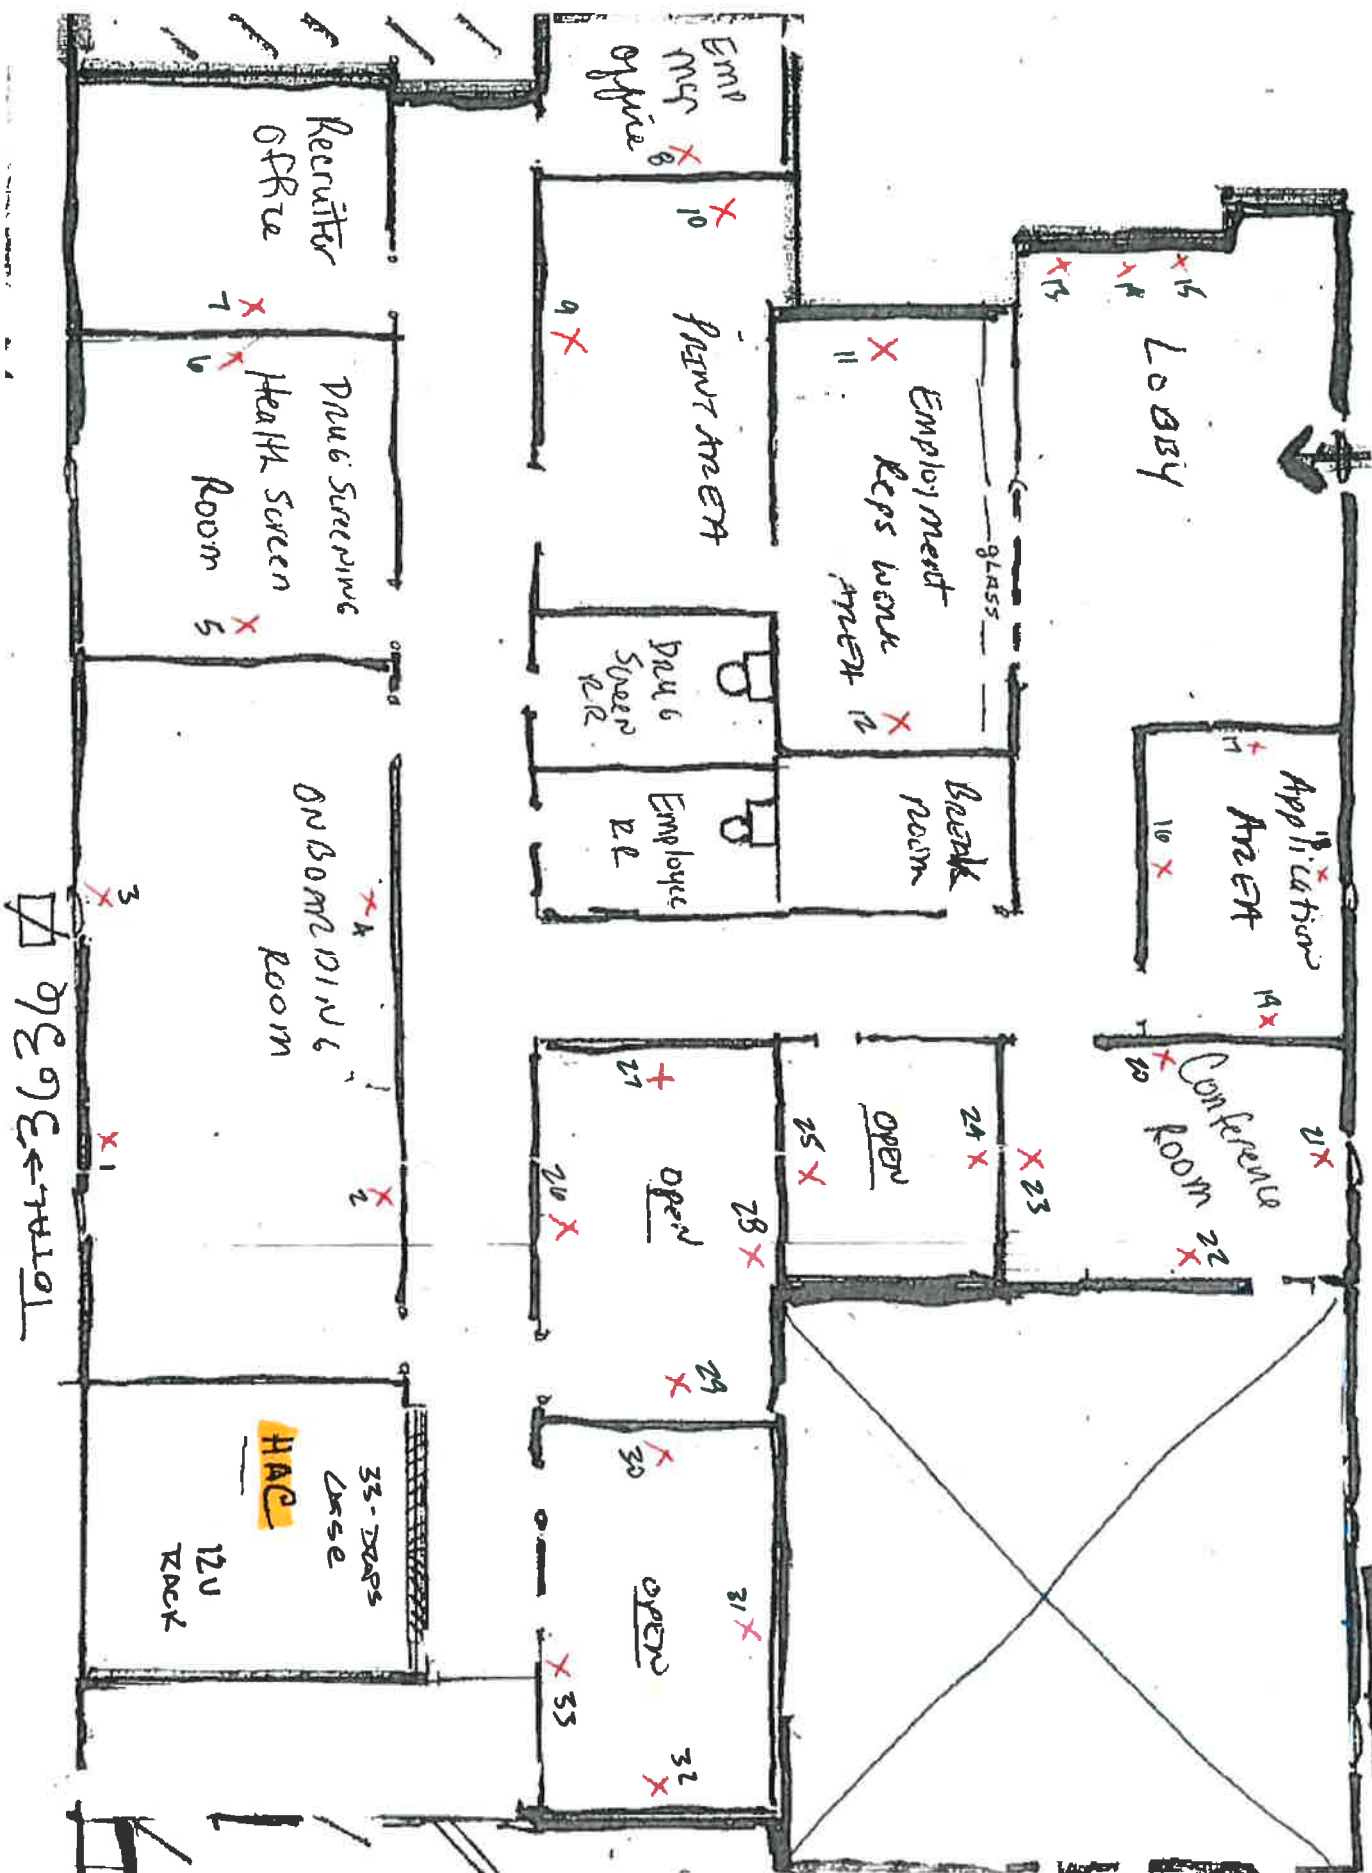

726936-7101